

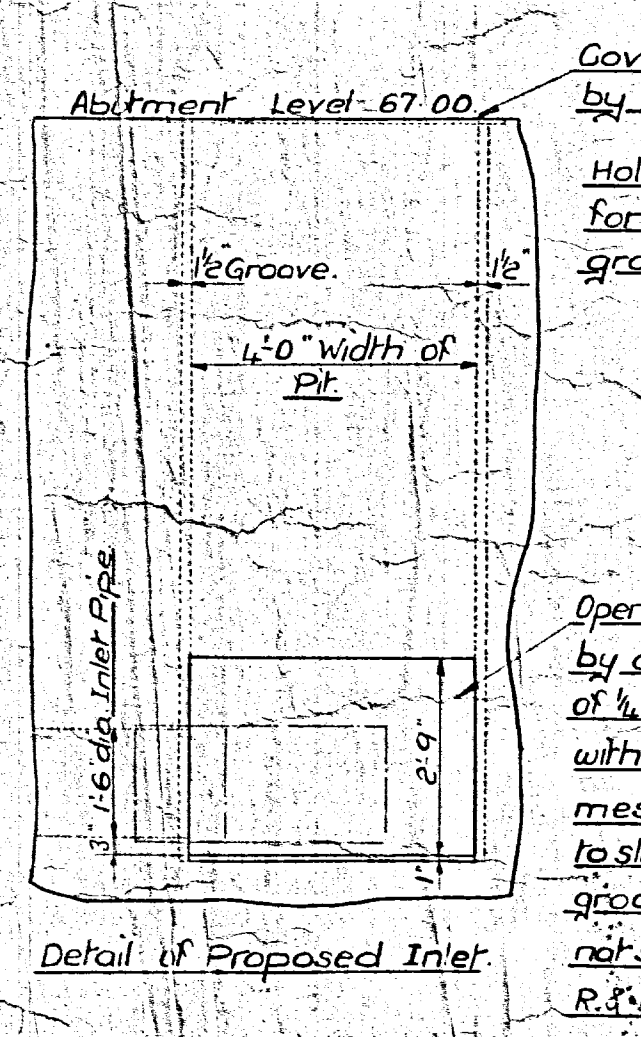
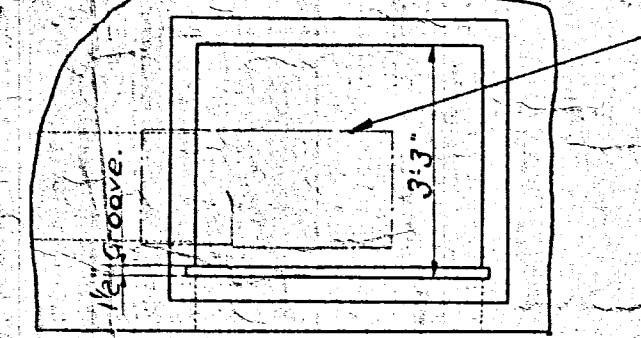


Key Plan
Scale - 3/8 inch = 1 foot

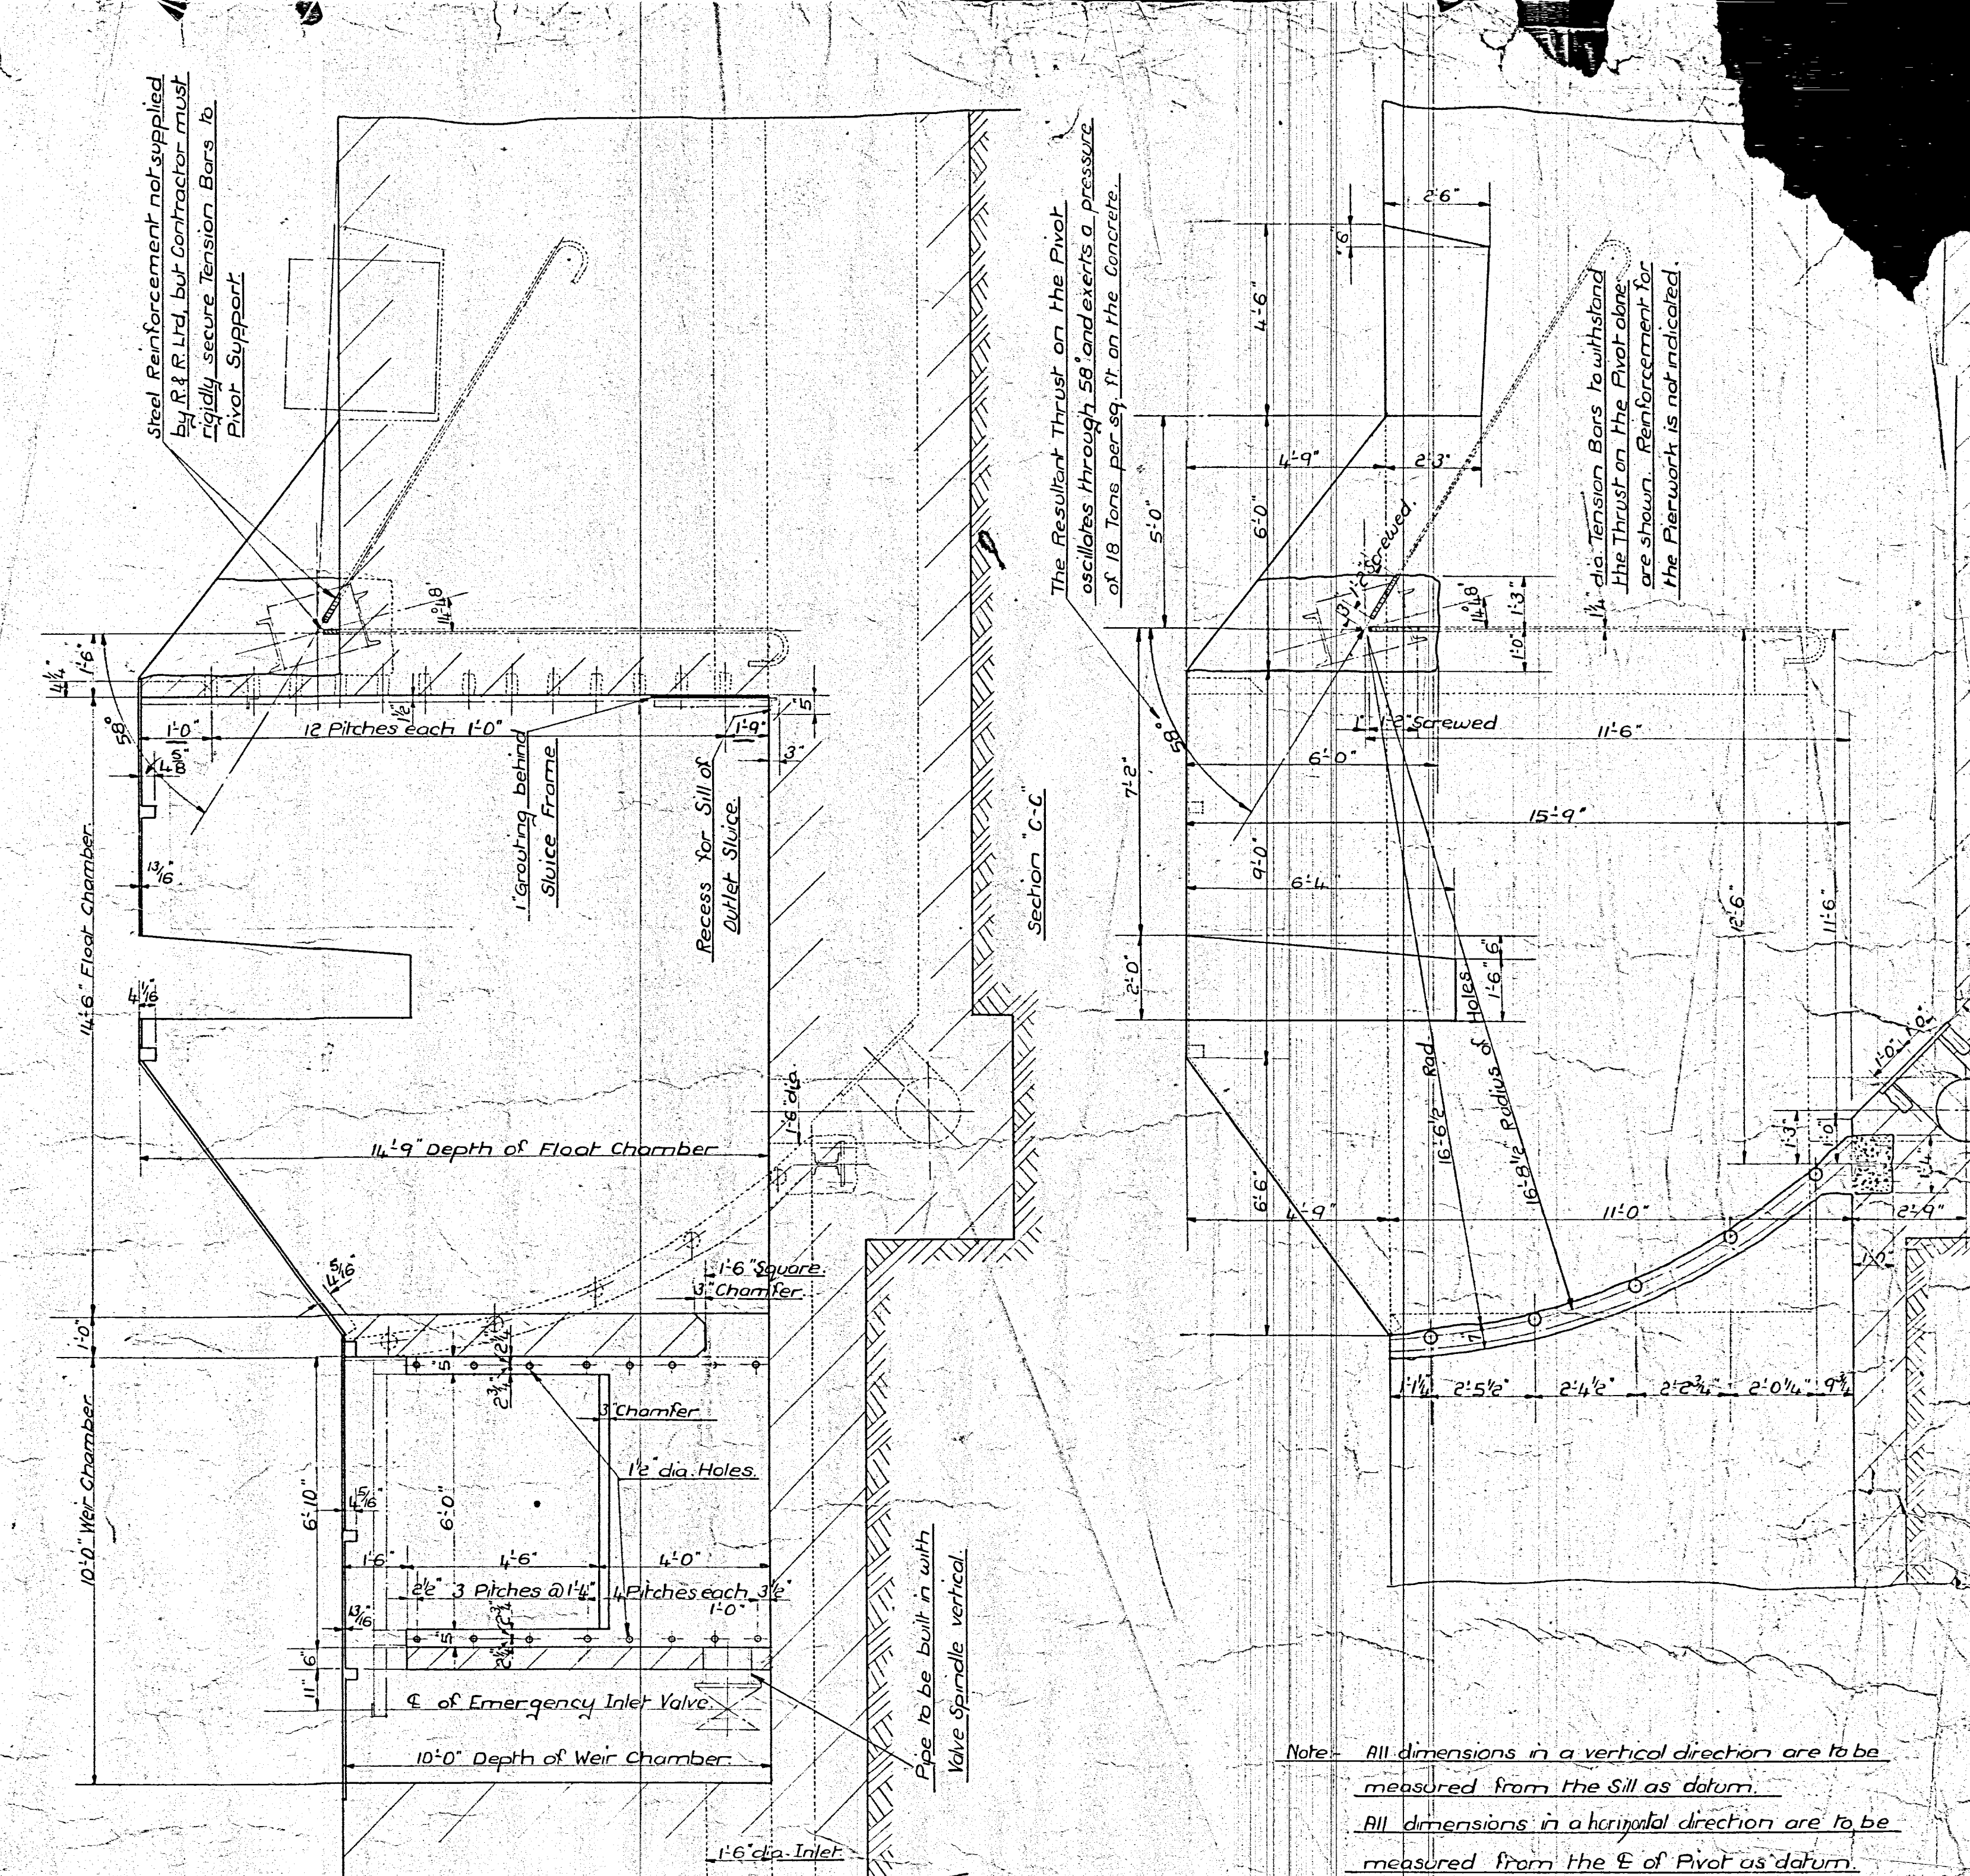

Screened Inlet supplied by R. & R. Ltd. but built in by Contractor.

Cover not supplied by R. & R. Ltd.
Holes 3" dia. x 6" deep for Step Irons to be grouted in.
Opening to be covered by a sliding screen of 1/4" bars covered with 1/4" square wire mesh. To be made to slide in vertical grooves. Screen not supplied by R. & R. Ltd.

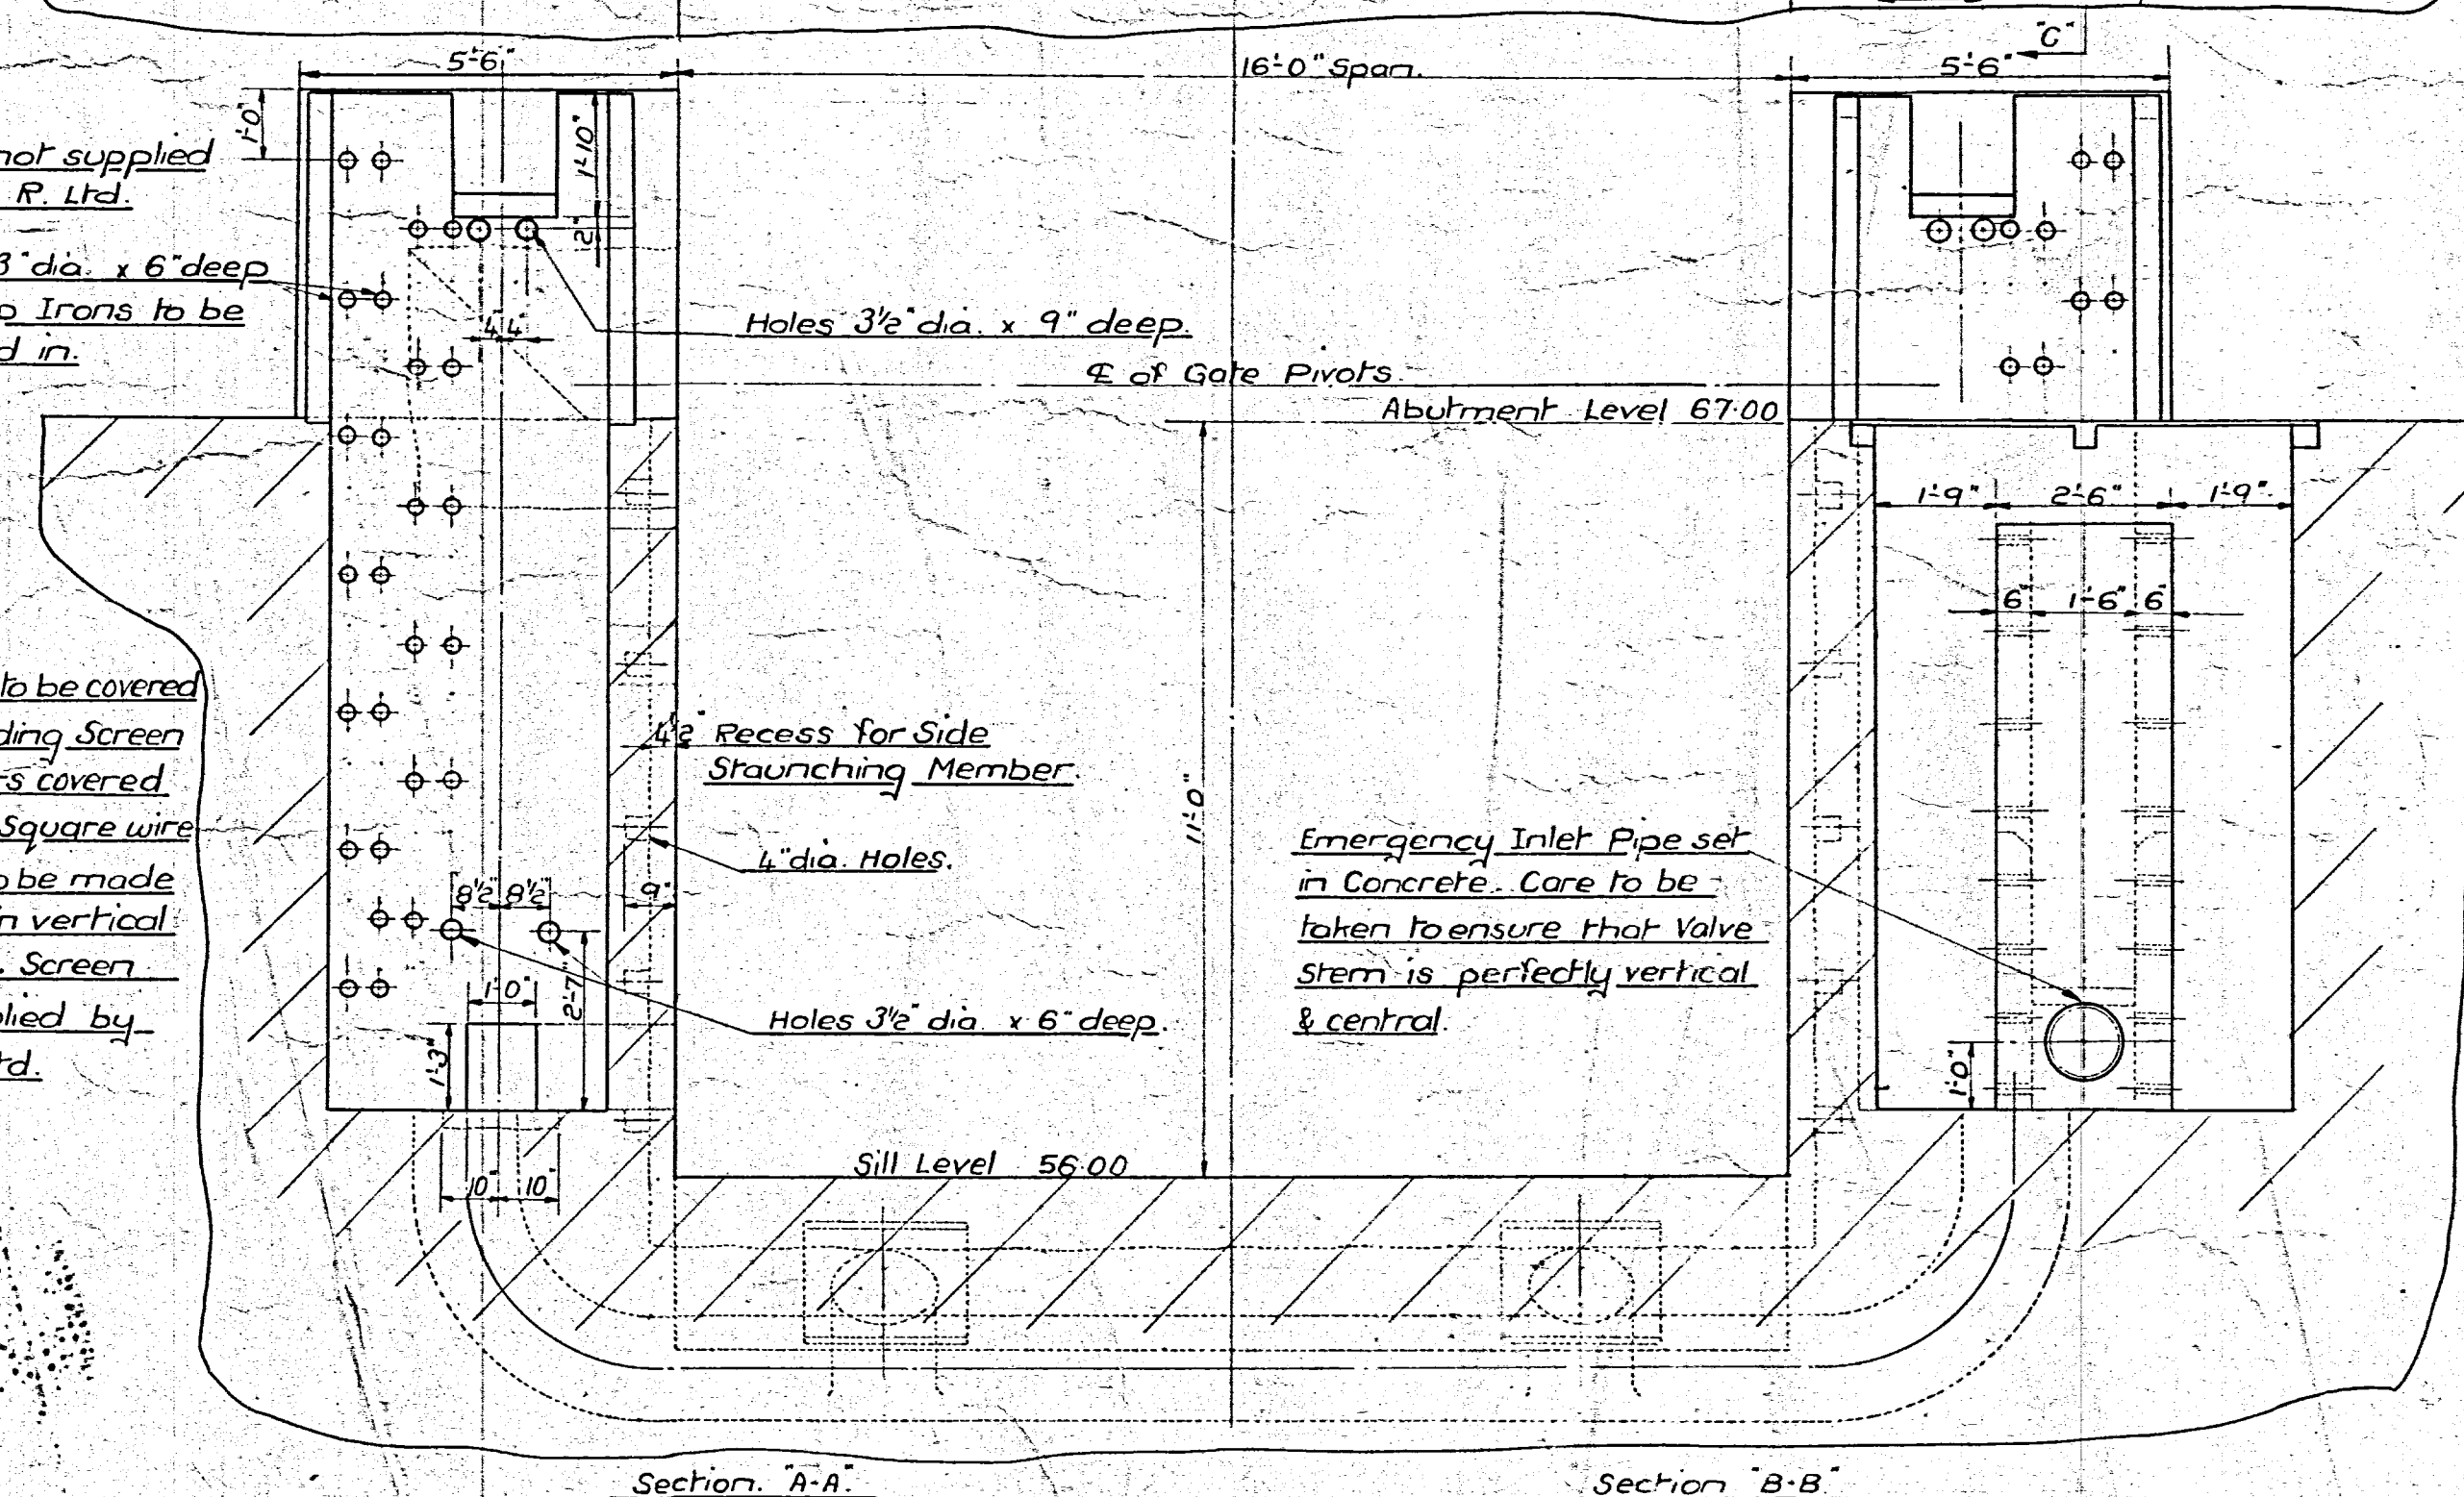

Scale - 3/8 inch = 1 foot

Note - All dimensions in a vertical direction are to be measured from the Sill as datum.
All dimensions in a horizontal direction are to be measured from the C of Pivot as datum.

1 Floor Chamber Altered. 4/16/37

53
67933

AUTOMATIC RADIAL GATE 16'-0" SPAN X 8'-3" DEEP X 9'-0" LIFT. OR. E 5260.

MASONRY.

STOUR (E. & S.) CATCHMENT BOARD - BURES MILL.